




Hodde & Hodde Land Surveying, Inc.
 Professional Land Surveying & Engineering
 613 E. Blue Bell Road · Brenham, Texas 77833
 979-836-5681 · 979-836-5683 (Fax)
 www.hoddesurveying.com

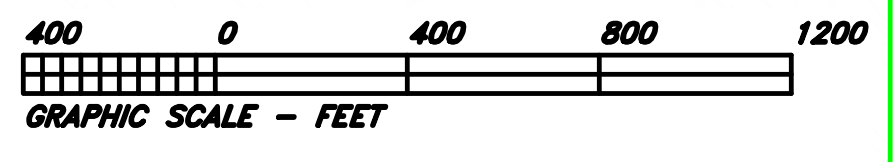

FRANKEL HOMES - W.O. NO. 0073
 GATES CROSSING SUBDIVISION
 32" X 42" @ 1" = 400'

(PRELIMINARY)

JON E. HODDE, PLS NO. 5187
 DATE: APRIL 6, 2023
 THE PURPOSE OF THIS DOCUMENT IS FOR
 PRELIMINARY REVIEW ONLY.
 PRELIMINARY. THIS DOCUMENT SHALL NOT
 BE RECORDED FOR ANY PURPOSE.

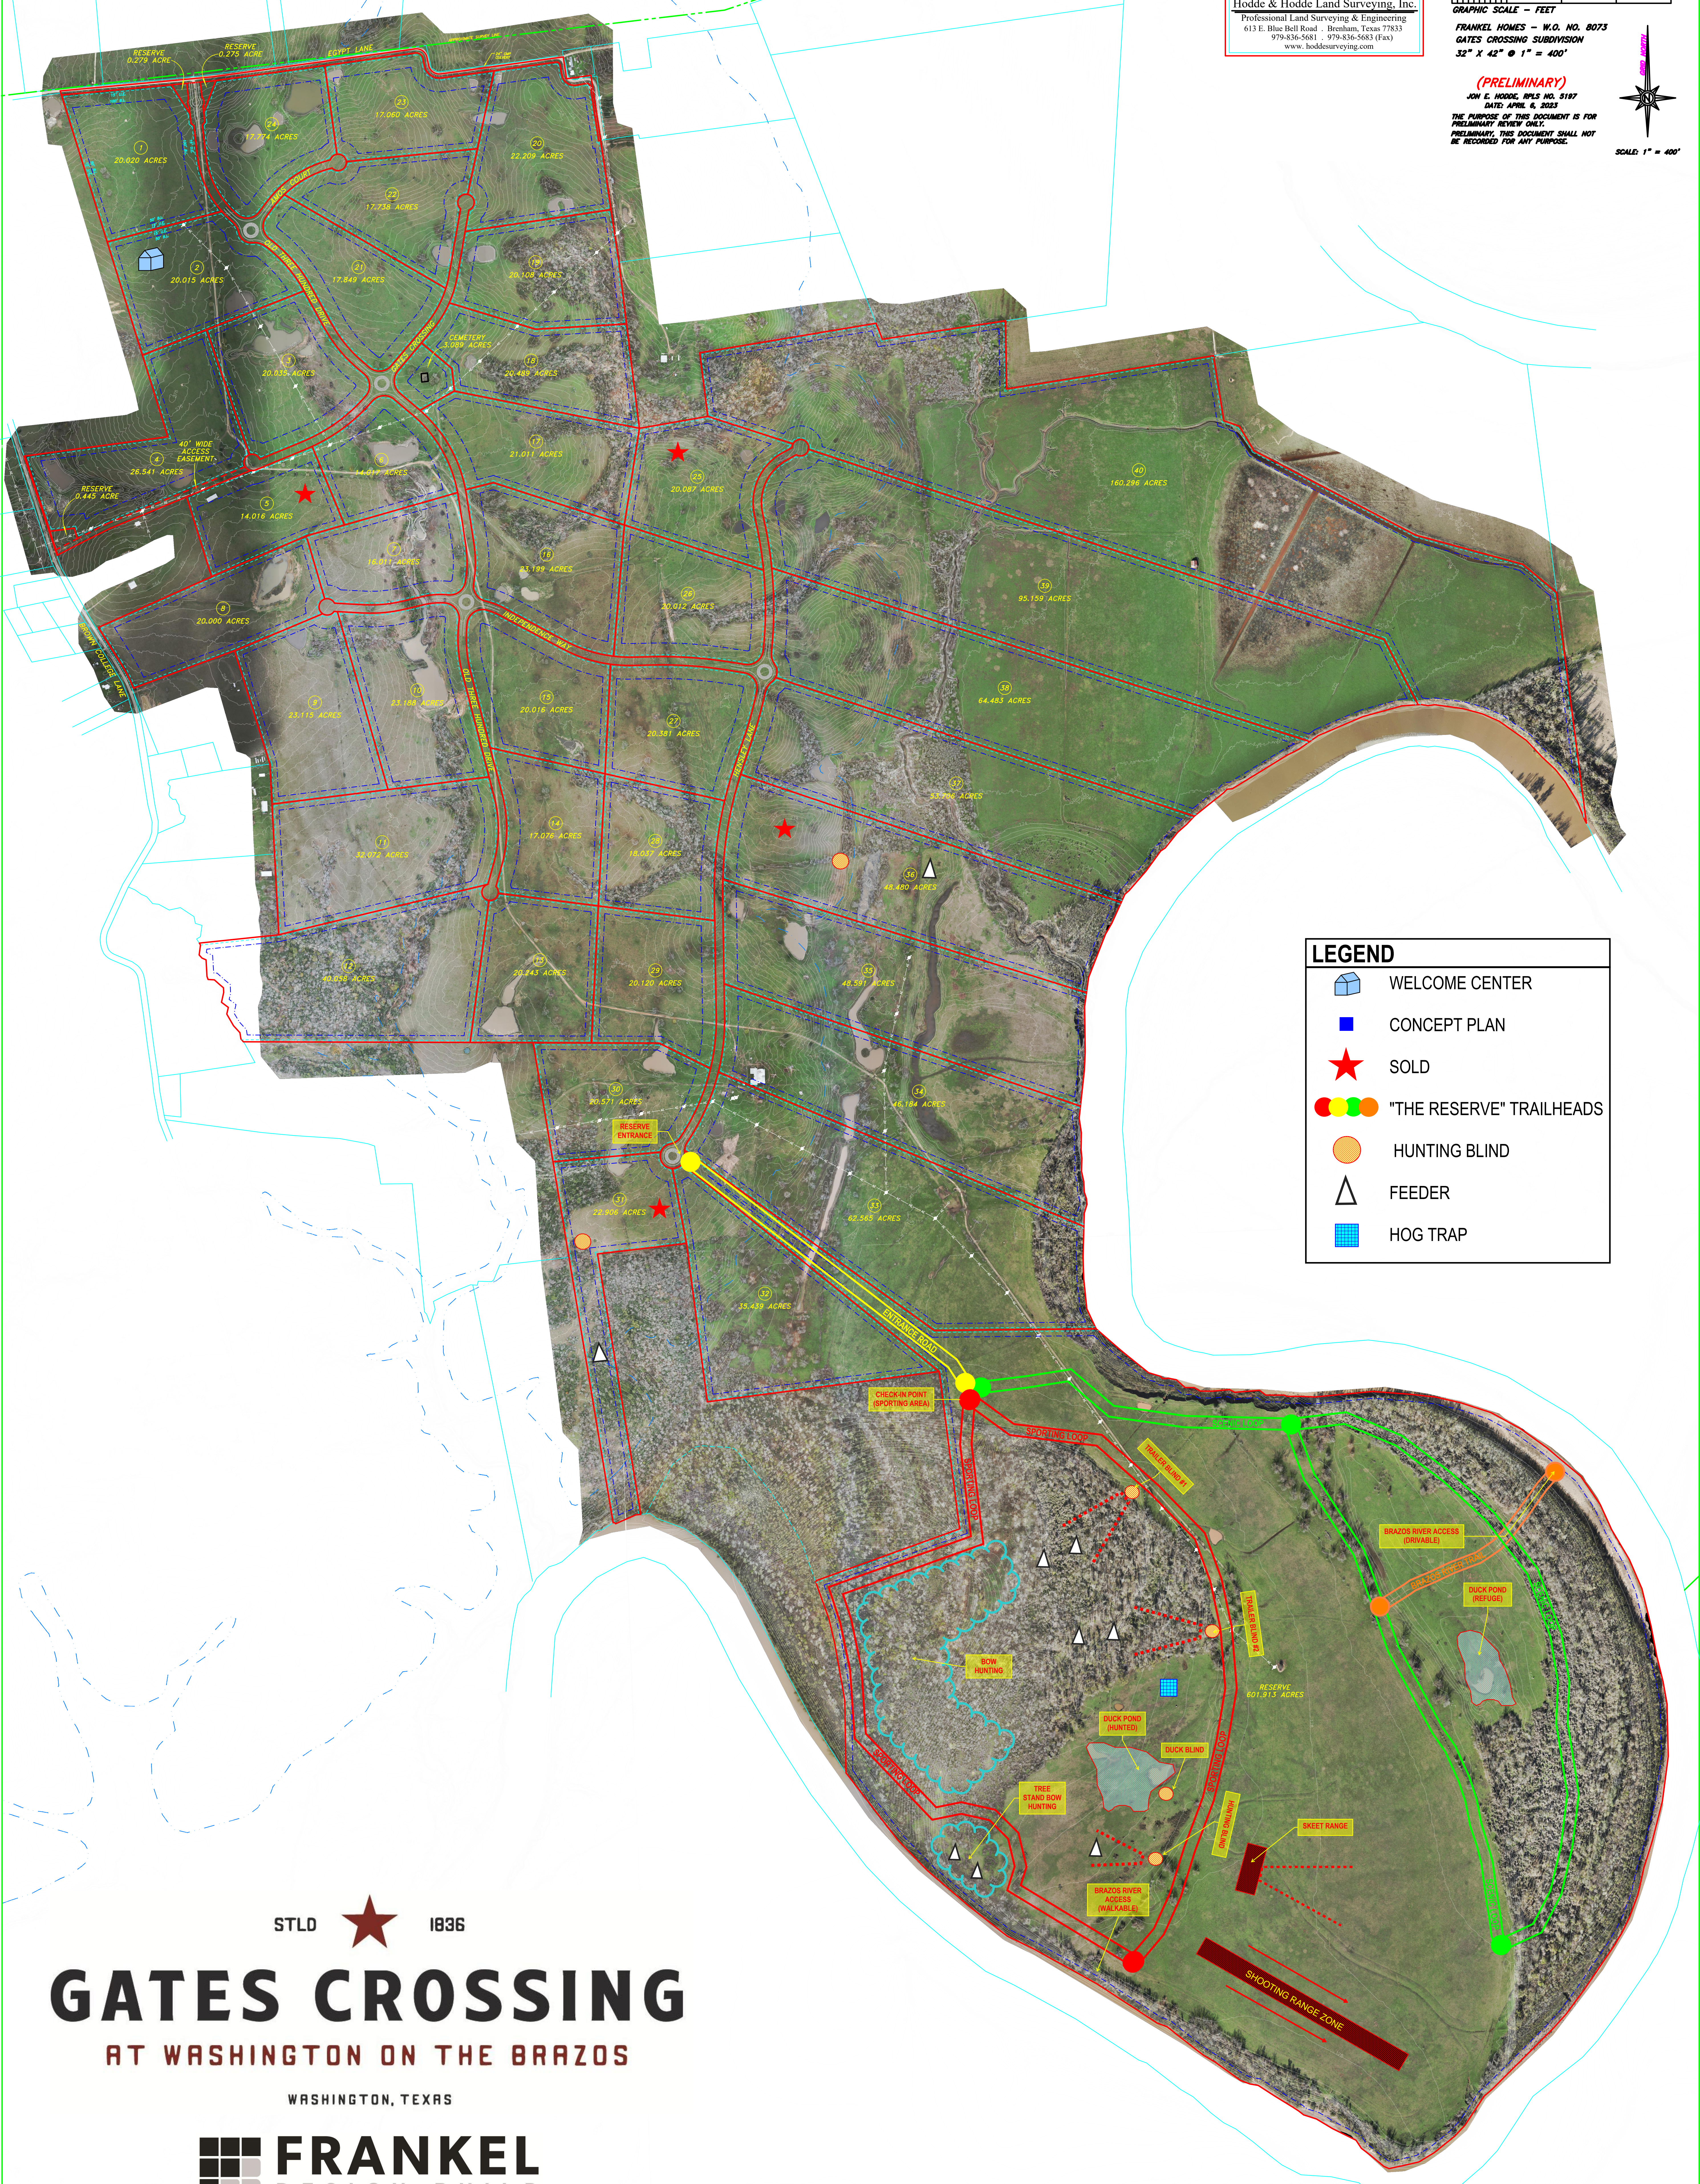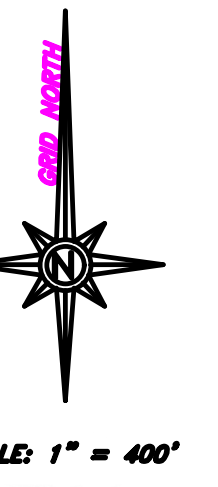

LEGEND	
	WELCOME CENTER
	CONCEPT PLAN
	SOLD
	"THE RESERVE" TRAILHEADS
	HUNTING BLIND
	FEEDER
	HOG TRAP

STLD 1836

GATES CROSSING

AT WASHINGTON ON THE BRAZOS

WASHINGTON, TEXAS

