

Hodde & Hodde Land Surveying, Inc.
Professional Land Surveying & Engineering
613 E. Blue Bell Road · Brenham, Texas 77833
979-836-5681 · 979-836-5683 (Fax)
www.hoddesurveying.com



400 0 400 800 1200

GRAPHIC SCALE - FEET

FRANKEL HOMES - W.O. NO. 8073
GATES CROSSING SUBDIVISION
32" X 42" @ 1" = 400'

(PRELIMINARY)

JON E. HODDE, PLS NO. 9187
DATE: APRIL 6, 2023
THE PURPOSE OF THIS DOCUMENT IS FOR
PRELIMINARY REVIEW ONLY.
PRELIMINARY. THIS DOCUMENT SHALL NOT
BE RECORDED FOR ANY PURPOSE.

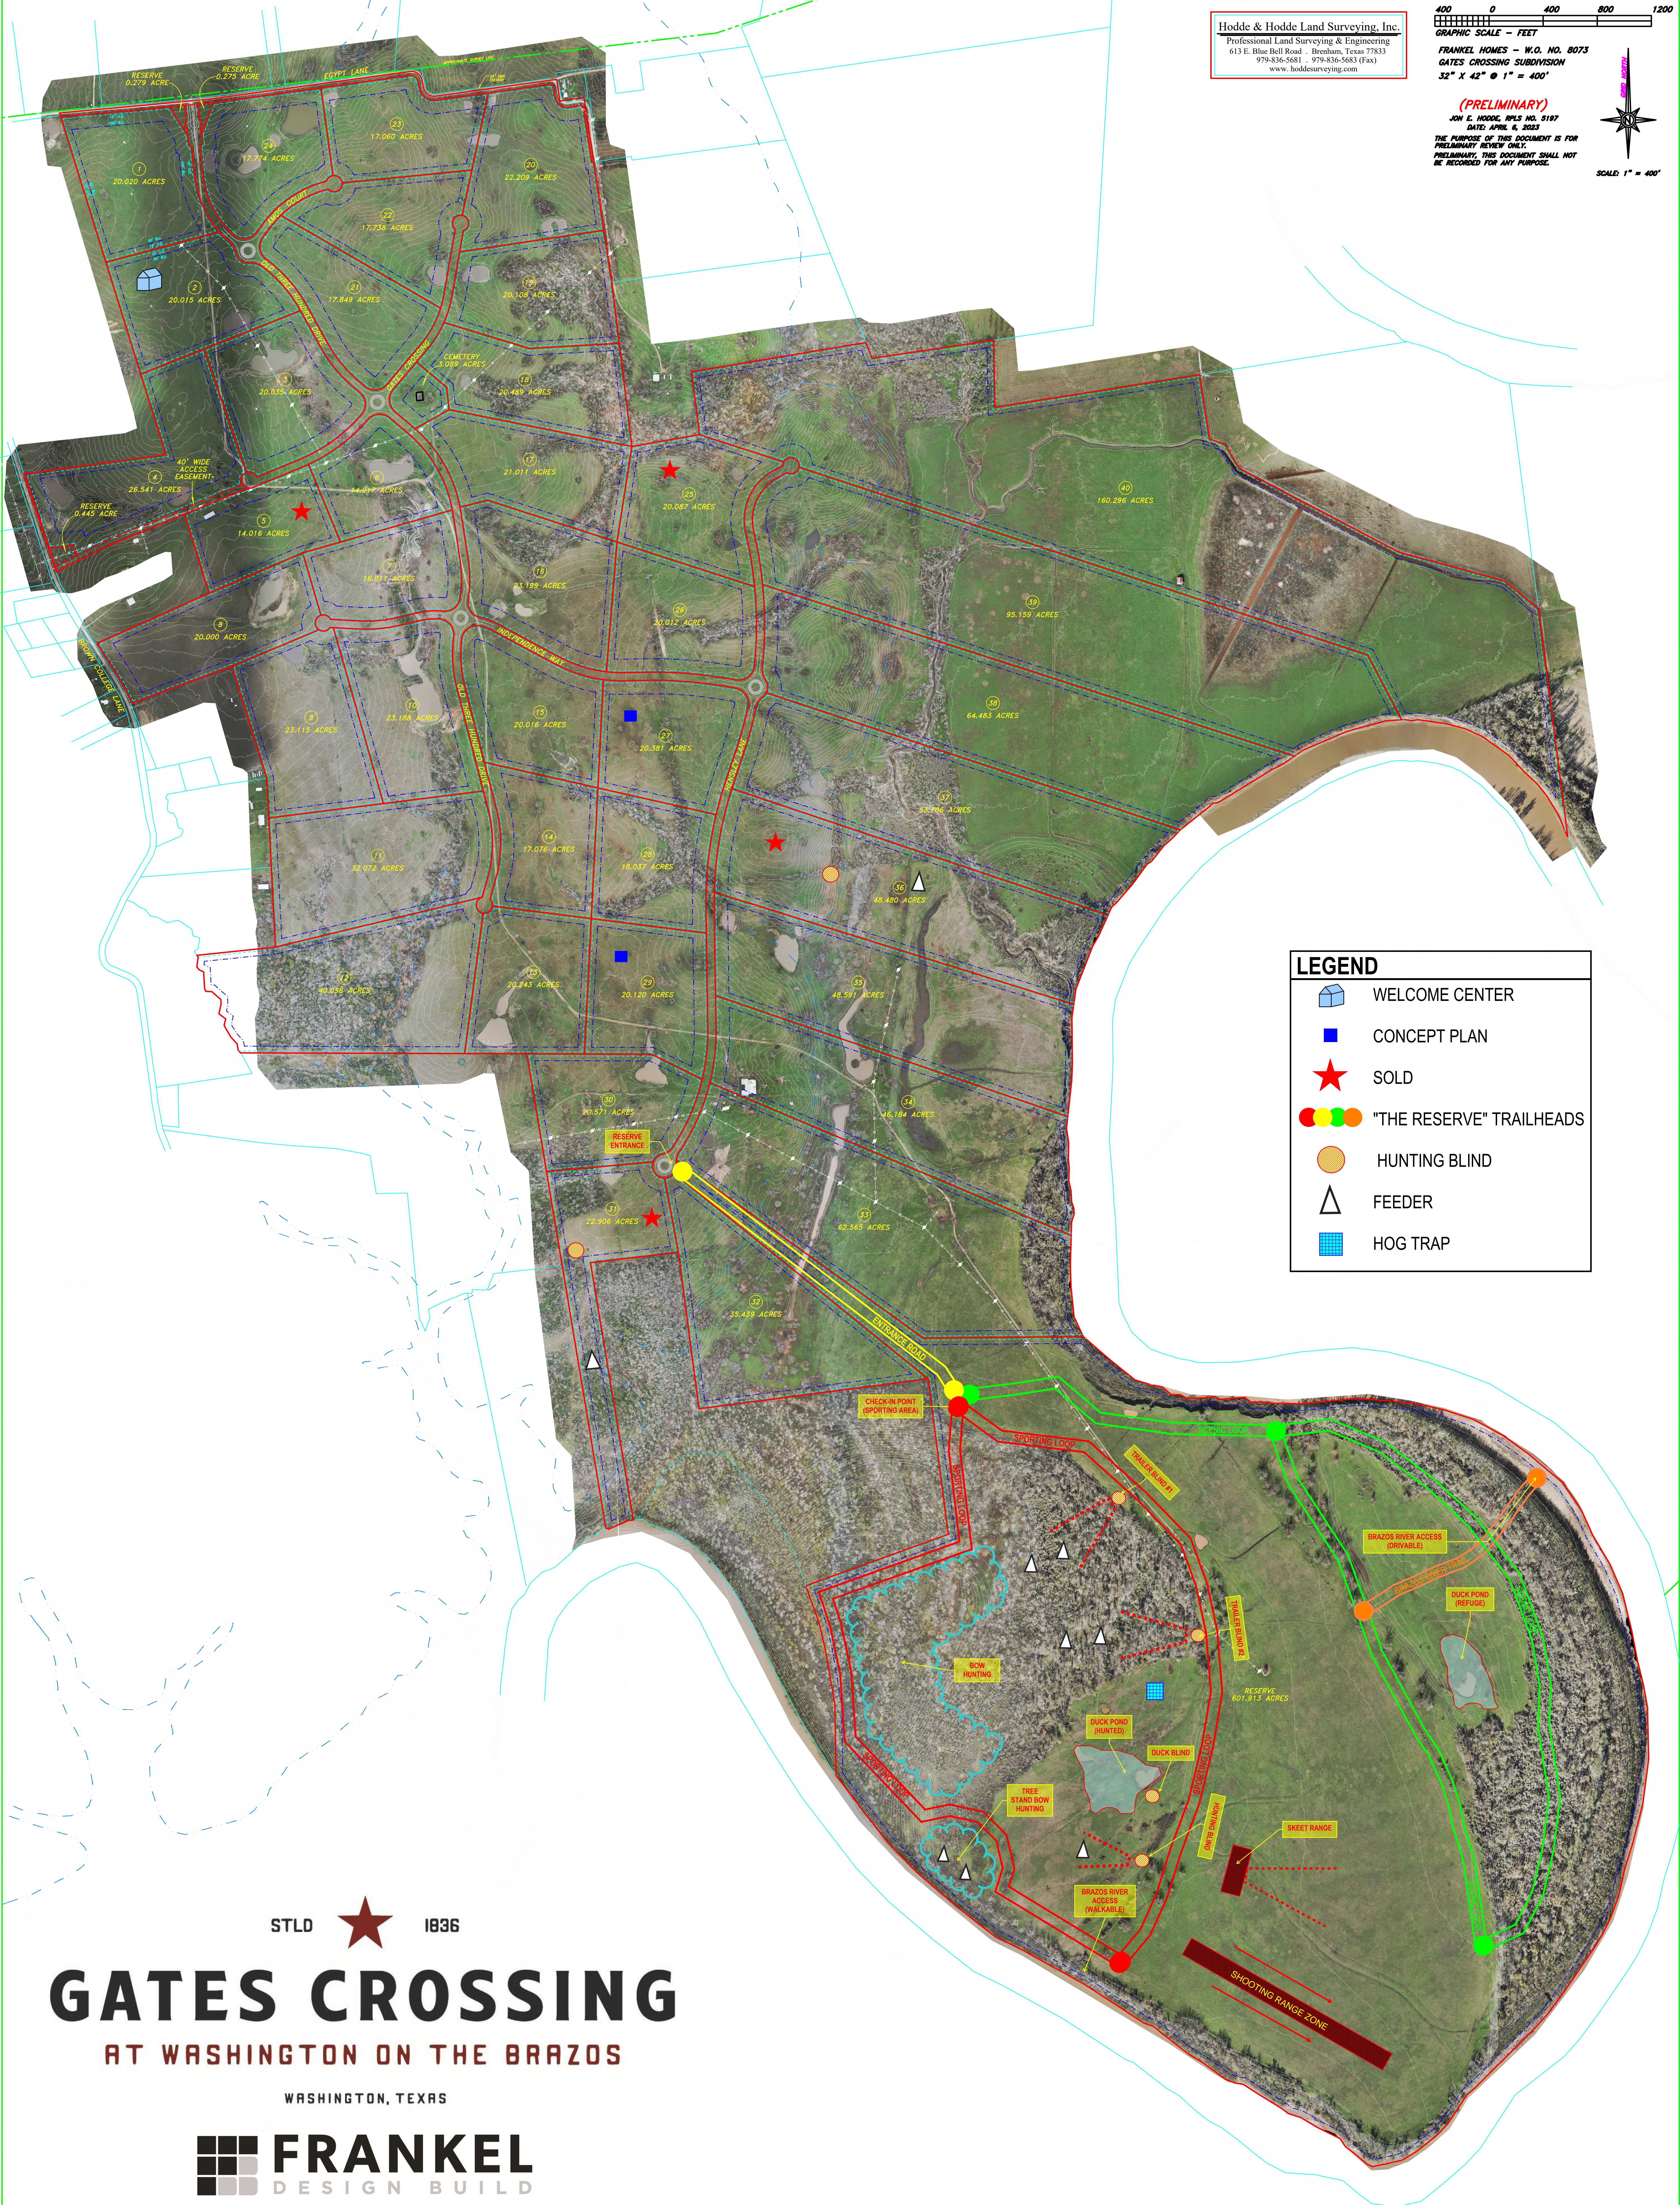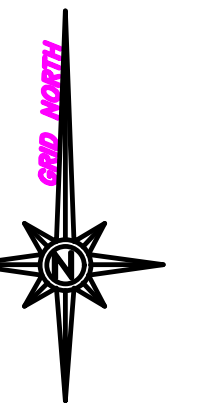

LEGEND	
	WELCOME CENTER
	CONCEPT PLAN
	SOLD
	"THE RESERVE" TRAILHEADS
	HUNTING BLIND
	FEEDER
	HOG TRAP

STLD 1836

GATES CROSSING

AT WASHINGTON ON THE BRAZOS

WASHINGTON, TEXAS

